

SECTION 39

24' DRIVE

SECTION 41
22' DRIVE

SEE WEST CENTRAL PART

NOTE:
THE LOT NUMBER IS PLACED IN THE UPPER
RIGHT HAND CORNER OF LOTS AS YOU FACE
THE LOT AND IS INDICATED THUS

LOCATION OF GRAVE MARKER IS SHOWN
THUS . ARROW INDICATES
DIRECTION MARKERS WILL FACE.

ALL LOTS ARE 2 GRAVE LOTS EXCEPT
WHERE OTHERWISE NOTED.

ALL 2 GRAVE LOTS ARE 6' X 9'
ALL 3 GRAVE LOTS ARE 9' X 9'

LOT SUMMARY:
1353 2 GRAVE LOTS
22 3 GRAVE LOTS
1375 TOTAL LOTS

HOLY CROSS CEMETERY
CLEVELAND, OHIO
WEST PART
SECTION 40
SCALE: 1"=20' J.G.-D.B. 8-8-88



SEE EAST CENTRAL PART

SECTION 30

22' DRIVE

3999	3893	3793	3693	3593	3493	3393	3293	3193	3093	2993	2893	2793	2693	2593	2493	2393	2293	2193	2093	1993	1893	1793	1693	1593	1493	1393	1293	1193	1093	993	893	793	693	593	493	393
3998	3892	3792	3692	3592	3492	3392	3292	3192	3092	2992	2892	2792	2692	2592	2492	2392	2292	2192	2092	1992	1892	1792	1692	1592	1492	1392	1292	1192	1092	992	892	792	692	592	492	392
3997	3891	3791	3691	3591	3491	3391	3291	3191	3091	2991	2891	2791	2691	2591	2491	2391	2291	2191	2091	1991	1891	1791	1691	1591	1491	1391	1291	1191	1091	991	891	791	691	591	491	391
3966	3860	3760	3660	3560	3460	3360	3260	3160	3060	2960	2860	2760	2660	2560	2460	2360	2260	2160	2060	1960	1860	1760	1660	1560	1460	1360	1260	1160	1060	960	860	760	660	560	460	360

 SEE WEST PART


NOTE:
 THE LOT NUMBER IS PLACED IN THE UPPER
 RIGHT HAND CORNER OF LOTS AS YOU FACE
 THE LOT AND IS INDICATED THUS 
 LOCATION OF GRAVE MARKER IS SHOWN
 THUS  . ARROW INDICATES
 DIRECTION MARKERS WILL FACE.

ALL LOTS ARE 2 GRAVE LOTS EXCEPT
 WHERE OTHERWISE NOTED.
 ALL 2 GRAVE LOTS ARE 6' X 9'
 ALL 3 GRAVE LOTS ARE 9' X 9'
 LOT SUMMARY:
 1155 2 GRAVE LOTS
 84 3 GRAVE LOTS
 1239 TOTAL LOTS

HOLY CROSS CEMETERY
 CLEVELAND, OHIO
 WEST CENTRAL PART
 SECTION 40

SCALE: 1"=20' J.G.-D.B. 3-4-88


AS BUILT 8-10-88

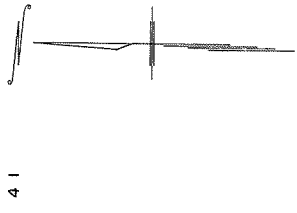

SEE EAST PART

SECTION 30

22' DRIVE

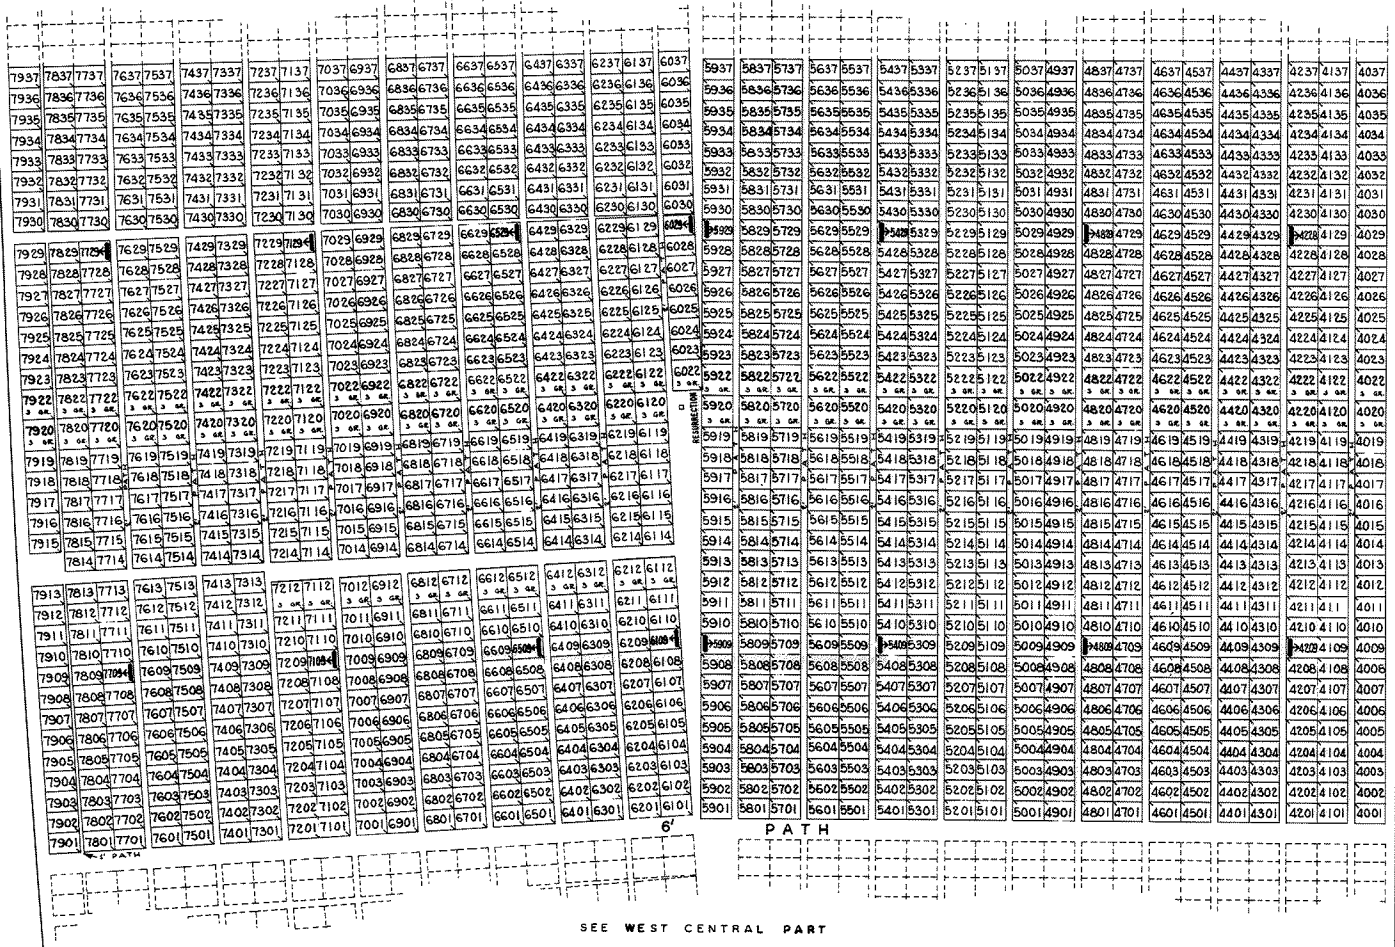

22' DRIVE

SECTION 40

NOTE:
 THE LOT NUMBER IS PLACED IN THE UPPER
 RIGHT HAND CORNER OF LOTS AS YOU FACE
 THE LOT AND IS INDICATED THUS ↗

LOCATION OF GRAVE MARKER IS SHOWN
 THUS ↘. ARROW INDICATES
 DIRECTION MARKERS WILL FACE.

ALL LOTS ARE 2 GRAVE LOTS EXCEPT
 WHERE OTHERWISE NOTED.

ALL 2 GRAVE LOTS ARE 6' x 9'
 ALL 3 GRAVE LOTS ARE 9' x 9'

LOT SUMMARY:
 1316 2 GRAVE LOTS
 91 3 GRAVE LOTS
 1407 TOTAL LOTS

HOLY CROSS CEMETERY
 CLEVELAND, OHIO
 EAST CENTRAL PART
 SECTION 40

SCALE: 1"=20' J.G.-D.B. 2-20-88

AS BUILT 3-10-88

